
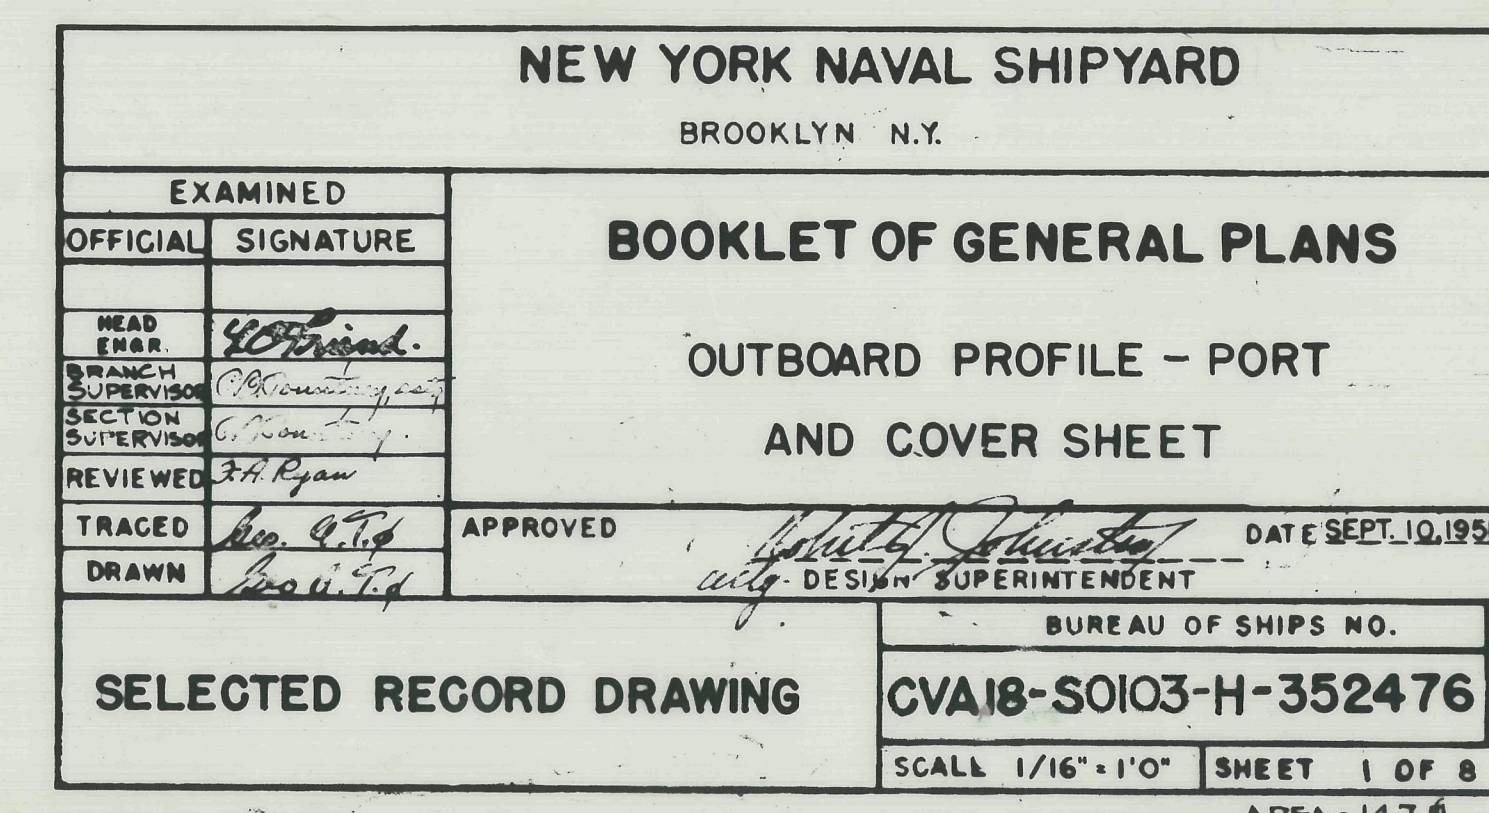


AIRCRAFT CARRIER CVS18


BOOKLET
OF
GENERAL PLANS
SELECTED RECORD DRAWING
PREPARED AT THE
NEW YORK NAVAL SHIPYARD

[illegible]

 

FLIGHT DECK

FLIGHT DECK
SCALE=1/16"=1'-0"
PLAN NO. CVA18-50103-352476
CVA18-PLATE 7 OF 19

 


FORECASTLE DECK

TYPE SECTIONS
SCALE=1/16"=1'-0"
PLAN NO. CVA18-50103-352476
CVA18-PLATE 19 OF 19

NEW YORK NAVAL SHIPYARD BROOKLYN, N.Y.	
BOOKLET OF GENERAL PLANS TYPE SECTIONS FLIGHT DECK	
EXAMINED	OFFICIAL SIGNATURE
DESIGNED	DATE
DRAWN	DATE
TRACED	DATE
APPROVED	DATE
BUREAU OF SHIPS NO. 1000	
CVA 18-50103-H-352476	
SCALE: 1/16"=1'-0"	
SHEET 8 OF 8	

CONFIDENTIAL

PLAN NO. CNA 18-20103-352476

 


CONFIDENTIAL

ABBREVIATIONS

1. LIFE NET BARGE
2. LIFE NET BARGE
GALLERY DECK
SCALE: 1/16" = 1'-0"
PLAN NO. CNA 18-20103-352476
CNA 18-PLATE 8 OF 19

 


CONFIDENTIAL

ABBREVIATIONS


1. LIFE NET BARGE
2. LIFE NET BARGE
FORECASTLE DECK
SCALE: 1/16" = 1'-0"
PLAN NO. CNA 18-20103-352476
CNA 18-PLATE 9 OF 19


NEW YORK NAVAL SHIPYARD BROOKLYN, N.Y.	
BOOKLET OF GENERAL PLANS FORECASTLE & GALLERY DECKS.	
EXAMINED OFFICIAL SIGNATURE	DATE
REVIEWED	DATE
APPROVED	DATE
BUREAU OF SHIPS NO. REV.	
SELECTED RECORD DRAWING	CNA 18-20103-352476 SCALE: 1/16" = 1'-0" SHEET 4 OF 8

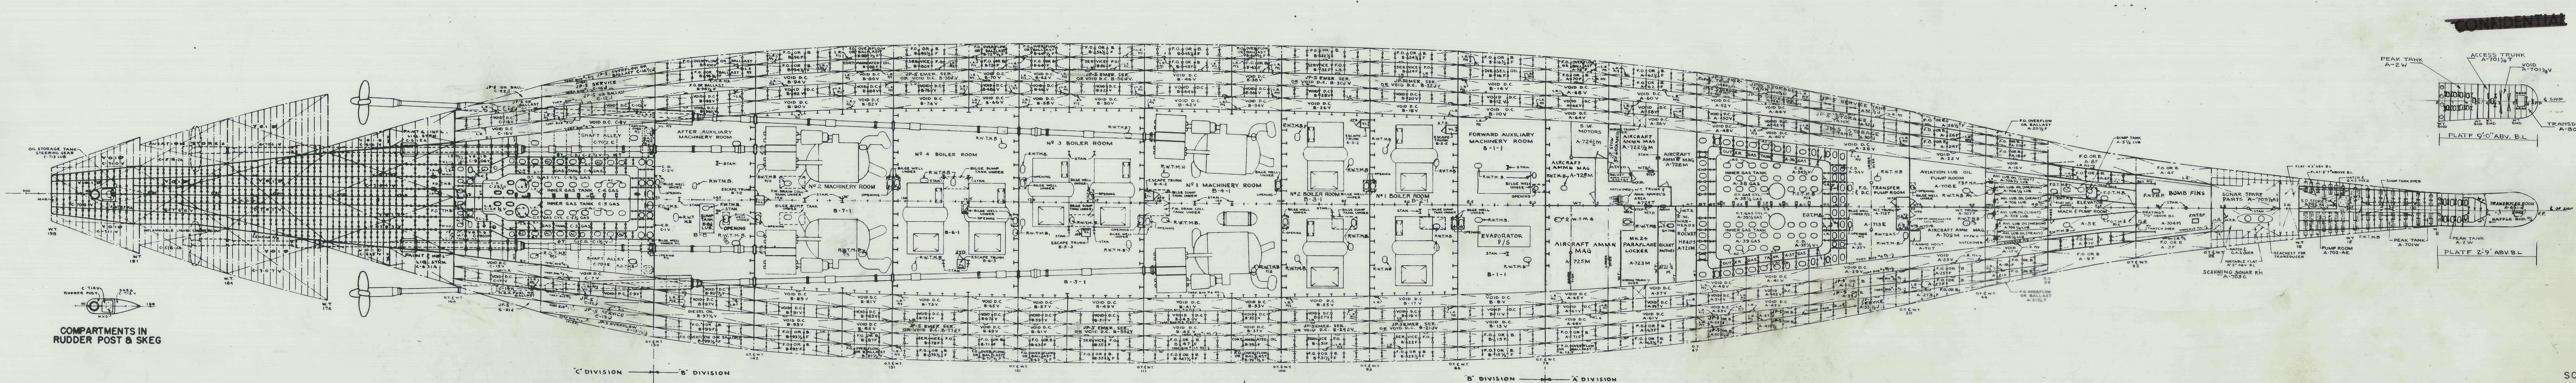

HOLD
SCALE: 1/16" = 1'-0"
PLAN NO CVA 18-50103-352476
CVA 18 - PLATE 16 OF 19

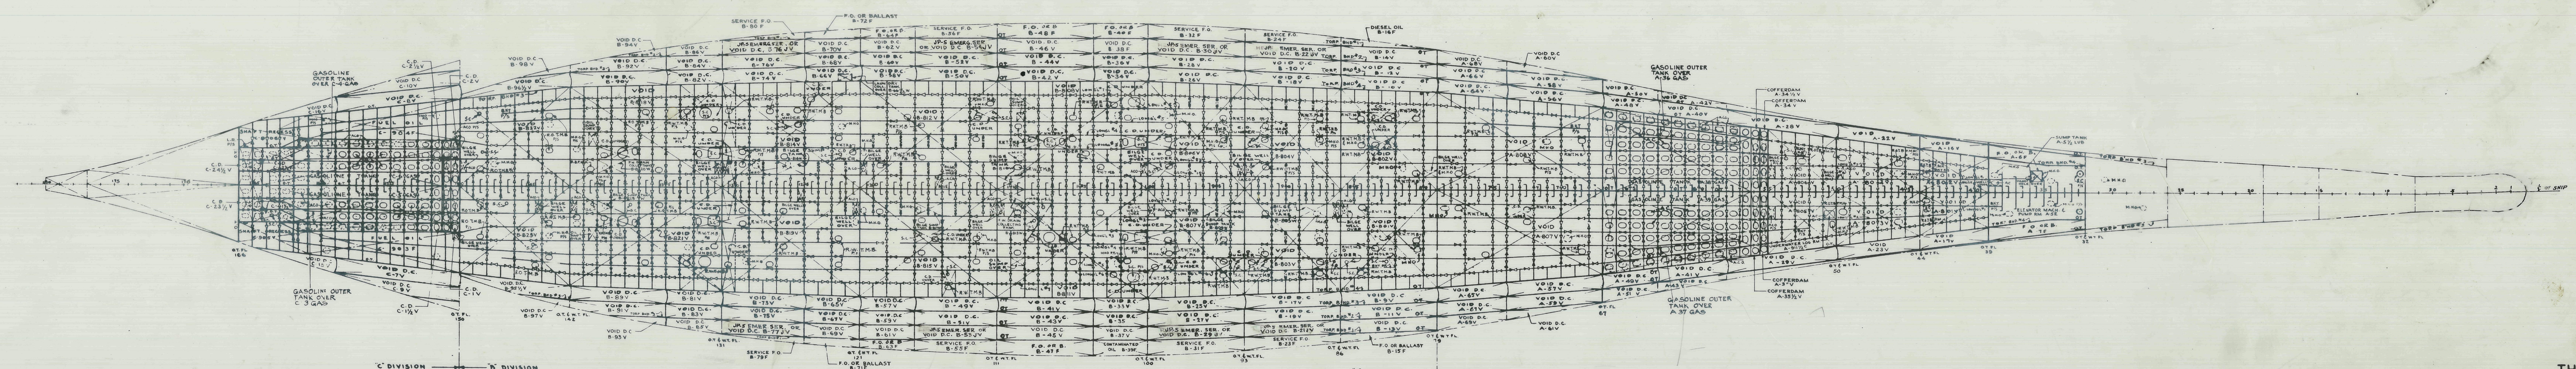

THIRD BOTTOM
SCALE: 1/16" = 1'-0"
PLAN NO CVA 18-50103-352476
CVA 18 - PLATE 17 OF 19

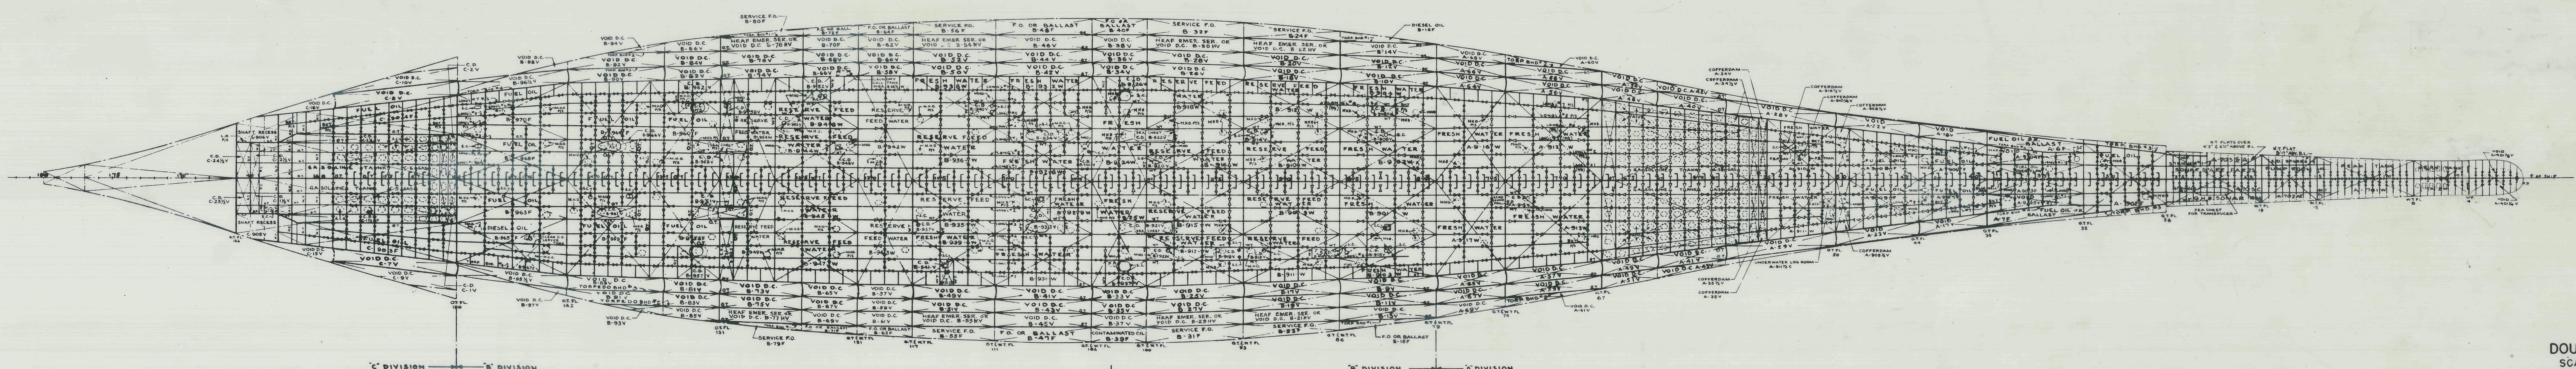

DOUBLE BOTTOM
SCALE: 1/16" = 1'-0"
PLAN NO CVA 18-50103-352476
CVA 18 - PLATE 18 OF 19

NEW YORK NAVAL SHIPYARD BROOKLYN, N.Y.	
EXAMINED	BOOKLET OF GENERAL PLANS
OFFICIAL SIGNATURE	DOUBLE BOTTOM, THIRD BOTTOM AND HOLD
DATE	1955
DESIGNED BY	DATE 10/1/55
REVIEWED BY	DATE 10/1/55
TRACED BY	DATE 10/1/55
DRAWN BY	DATE 10/1/55
APPROVED	
BUREAU OF SHIPS NO.	
SELECTED RECORD DRAWING	
CVA 18-50103-H-352476	
SCALE 1/16"=1'-0" SHEET 7 OF 8	